


R	DATE	DESCRIPTION
R	05/10/2016	ADDENDUM NO. 1
I/R	DATE	DESCRIPTION

60446021

PLAN AND PROFILE  
 CHURCH AVE

PP - 1


10-176

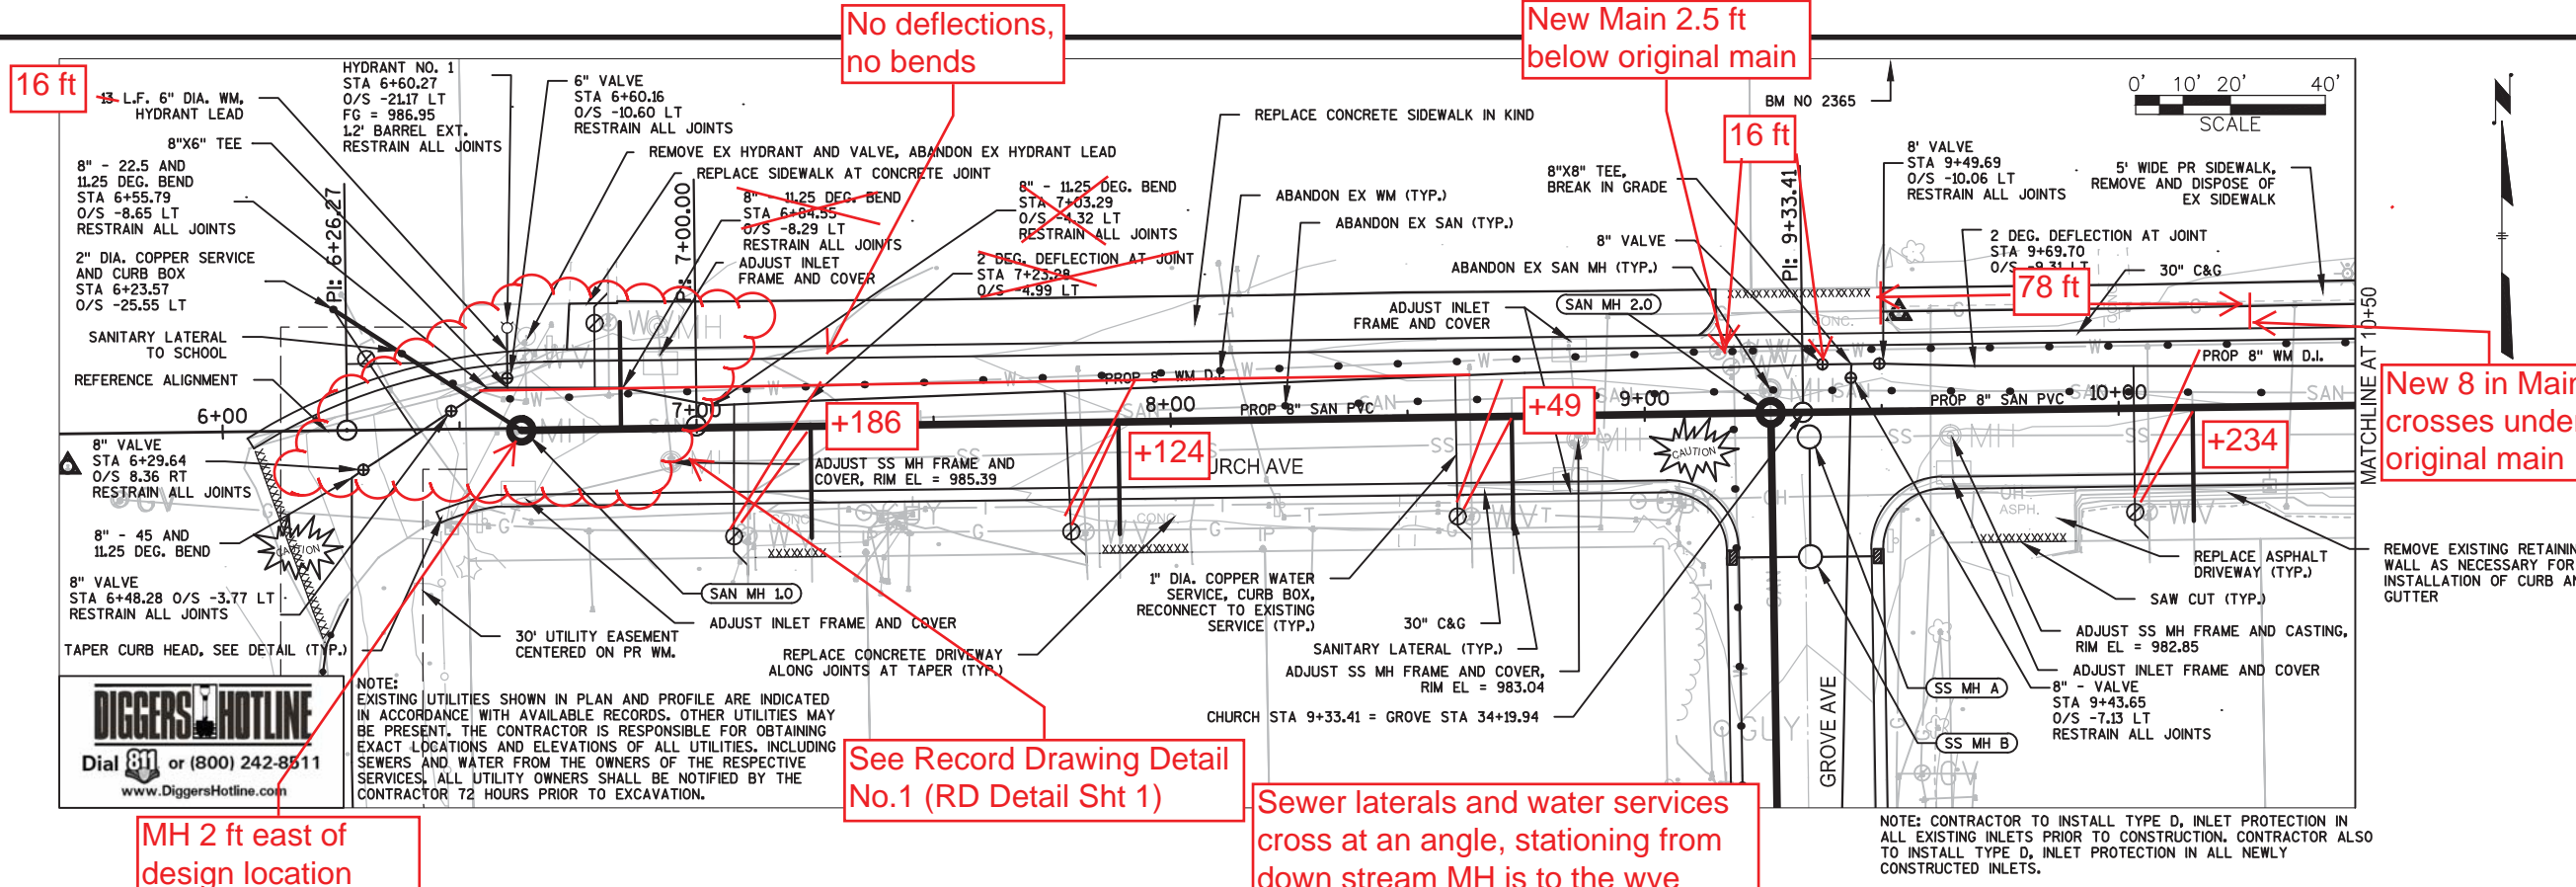

MH 2 ft east of design location

See Record Drawing Detail No.1 (RD Detail Sht 1)

Sewer laterals and water services cross at an angle, stationing from down stream MH is to the wye

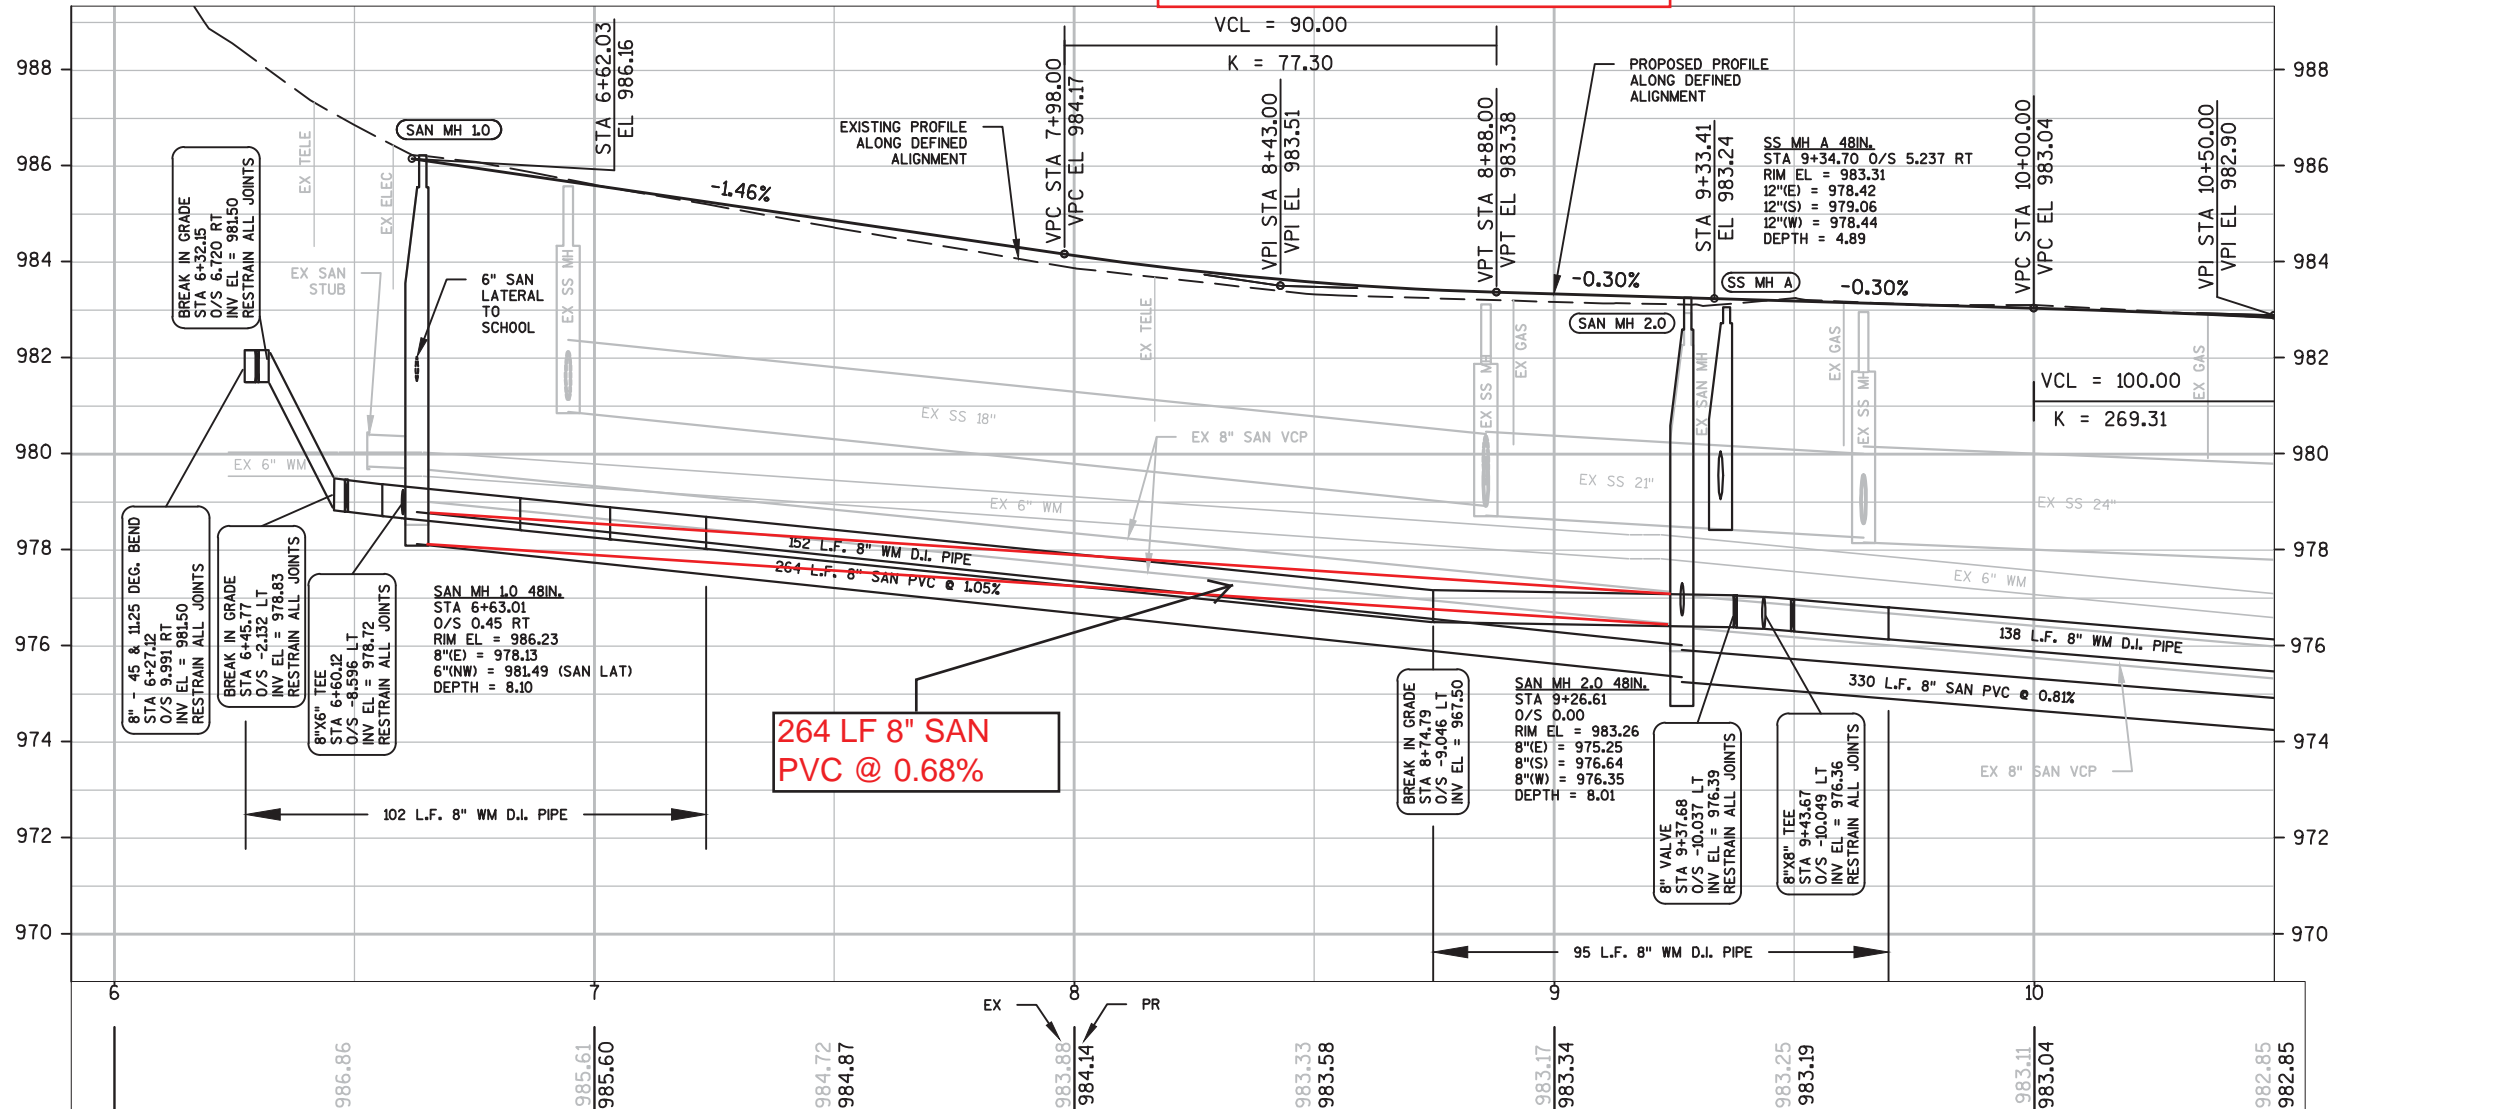

264 LF 8" SAN PVC @ 0.68%

ANSID 22' x 34' Approved: JTM  
 Designer: JCOA Checked: TPJ  
 Project Management Initials: JCOA  
 Plotted By: accolaj  
 Plot File Date Created: May/10/2016 1:22 PM  
 Layout-Sheet Name: PP-1  
 Filename: P:\60446021\900\_WORKING\910\_CAD\_WORKING\AE\_0305\_P1\_PP - CHURCH.DWG